


Homesite 69, Summit at Castle Pines Village - Estate

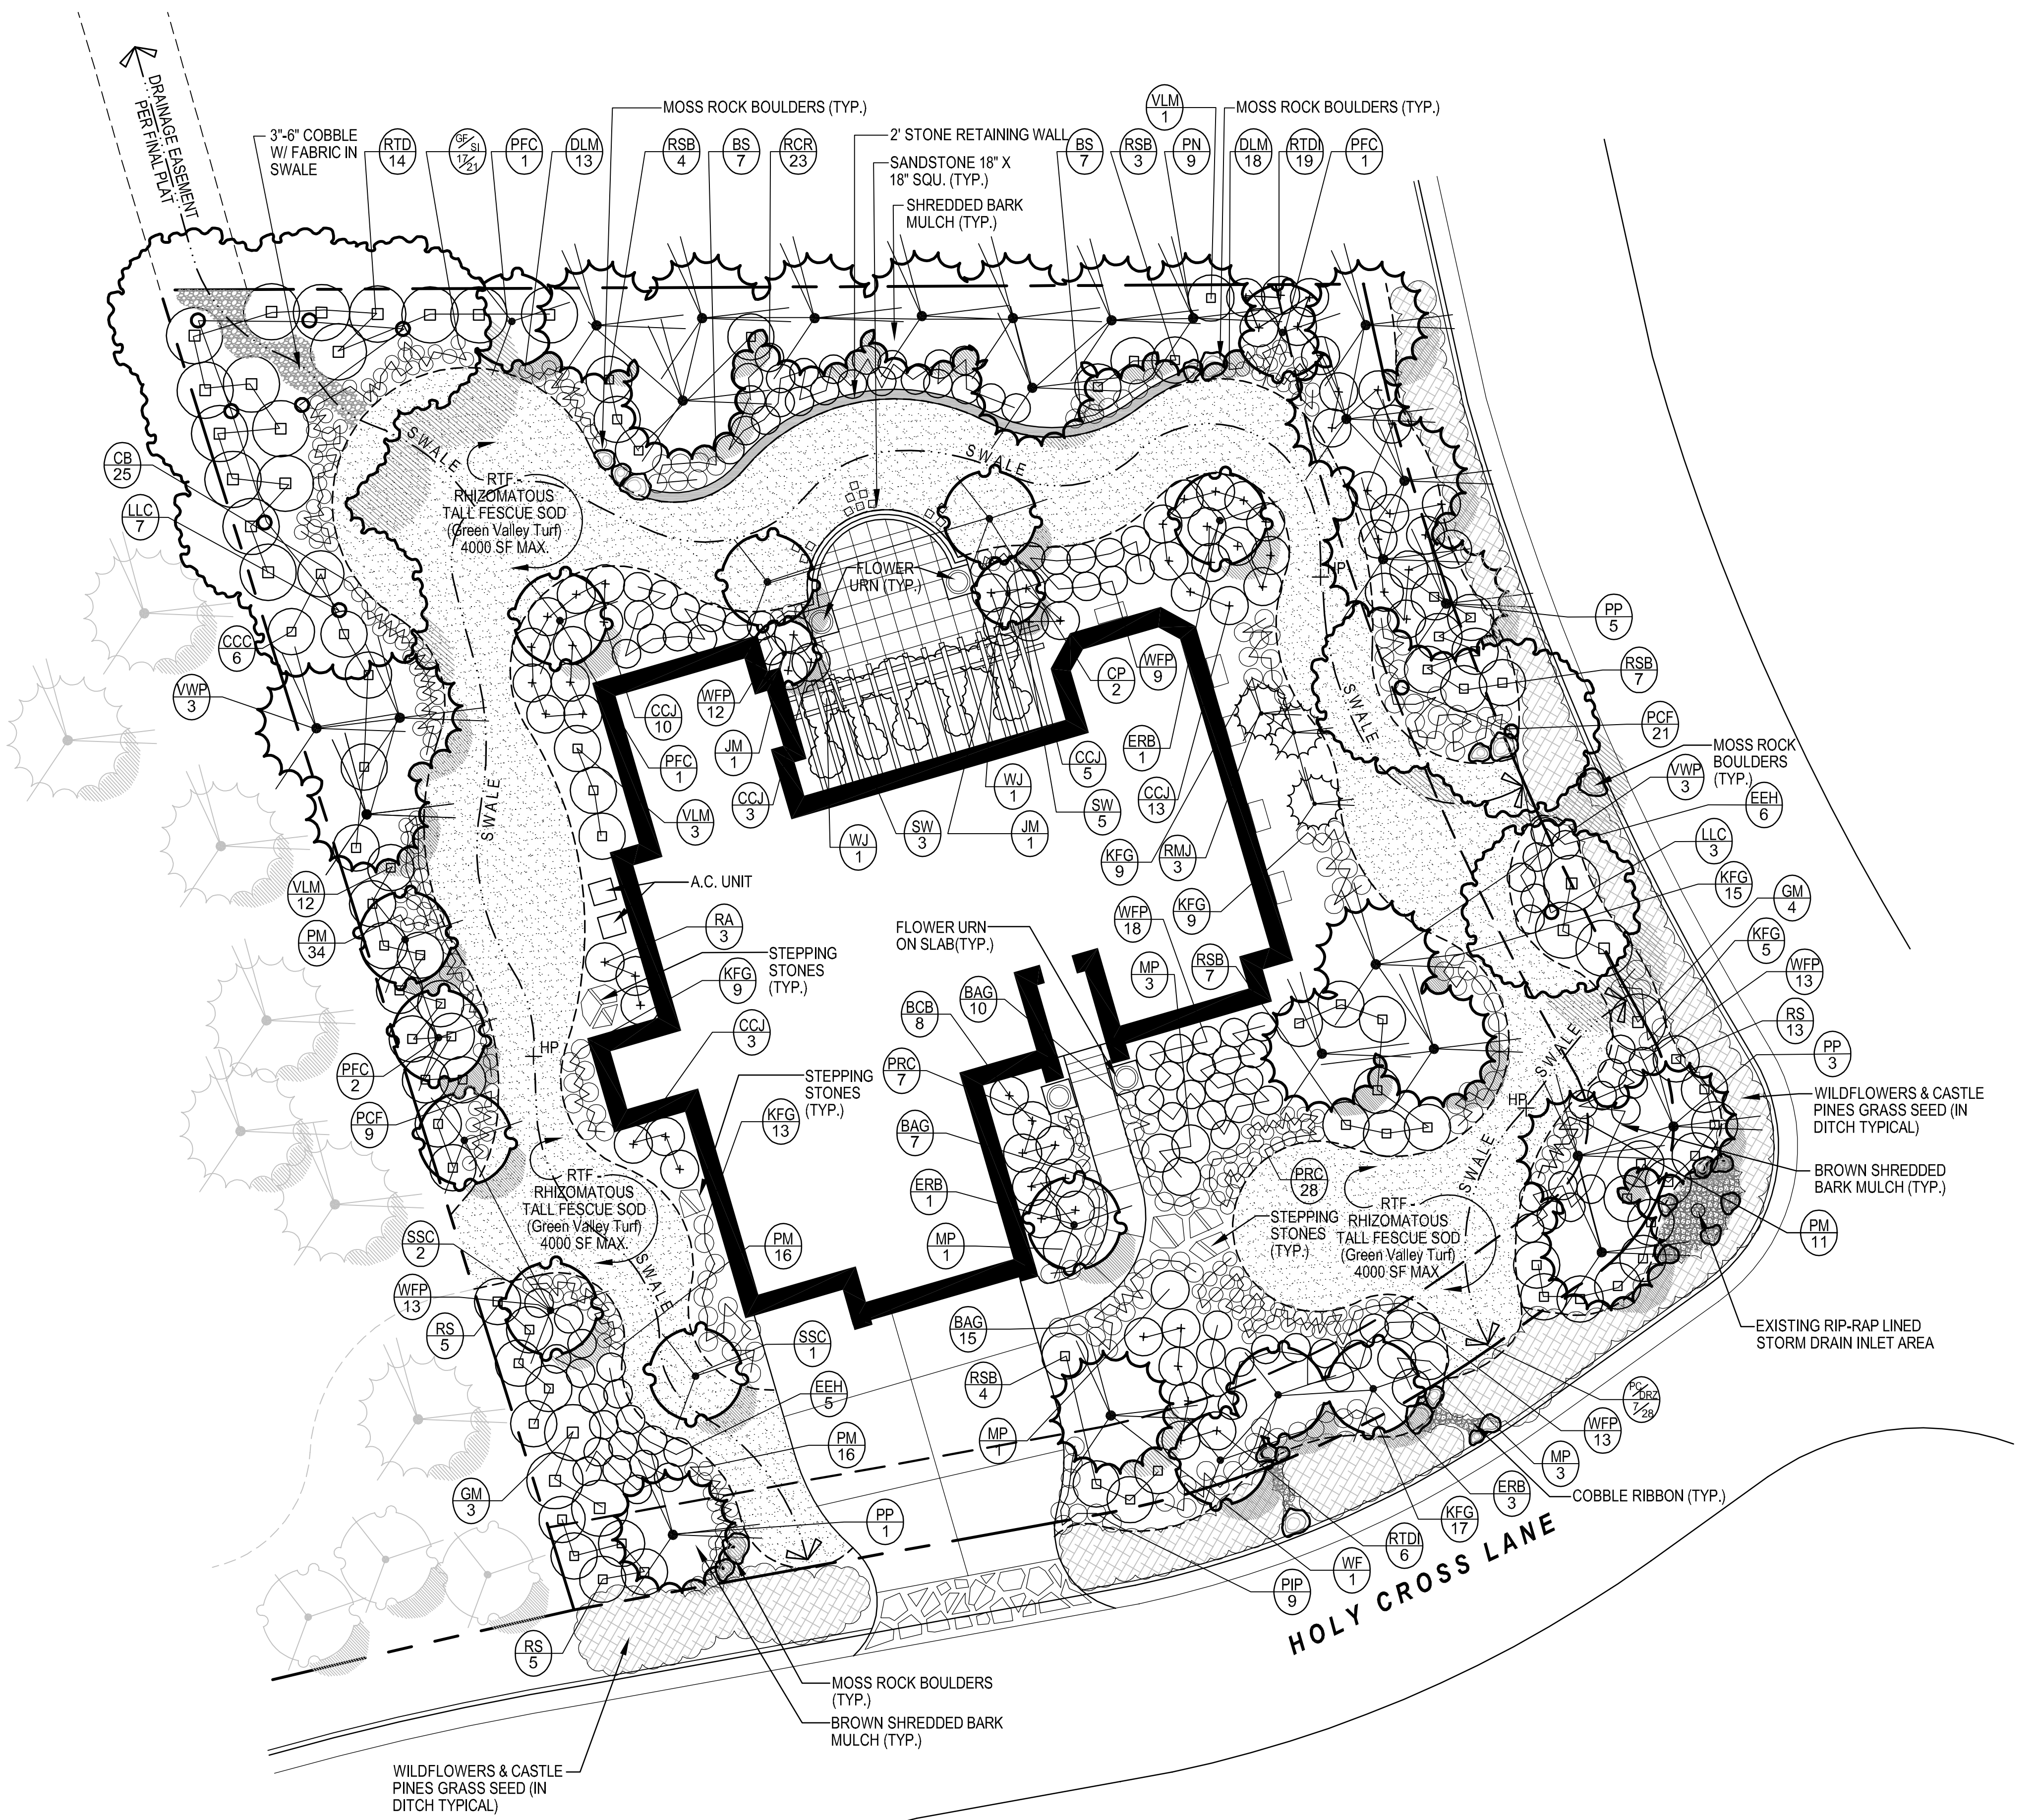

PLANTING SCHEDULE

DECIDUOUS CANOPY TREES

Qty.	Symbol	Common Name	Size
10	LLC	Lanceleaf Cottonwood	3"-Cal B & B
10	TOTAL		

ORNAMENTAL TREES

2	JM	Cutleaf Japanese Maple	15 Gallon
5	ERB	Eastern Red Bud	8'-10' multi-stem
3	SSC	Spring Snow Crab	2"-Cal B & B
5	PFC	Prairie Fire Crab	2"-Cal B & B
2	CP	Chanticleer Pear	2"-Cal B & B
17	TOTAL		

EVERGREEN TREES

9	PP	Ponderosa Pine	10'-12' Ht. B & B
1	WF	White Fir	12' Ht. B & B
9	PN	Austrian Pine	10'-12' Ht. B & B
6	VWF	Vanderwolf Pine	8'-10' Ht. B & B
25	TOTAL		

DECIDUOUS SHRUBS

25	RSB	Regent Serviceberry	5-Gal
25	RTDI	Isanti Redtwig Dogwood	5-Gal
14	RTD	Redtwig Dogwood	5-Gal
23	RCR	Red Carpet Rose	5-Gal
8	BCB	Rhododendron Roseum Elegans	5-Gal
78	WFP	St. Johns Wort	5-Gal
16	VLM	Common Purple Lilac	5-Gal
3	RA	Dwarf Korean Lilac	5-Gal
6	CCC	Canada Chokecherry	6'-8' Ht. B & B (Multi-Stem)
7	GM	Amur Maple	6'-8' Ht. B & B (Multi-Stem)
23	RS	Russian Sage	5-Gal
228	TOTAL		

EVERGREEN SHRUBS

3	RMJ	Rocky Mountain Juniper	5-Gal
34	CCJ	Calgery Carpet Juniper	5-Gal
8	MP	Dwarf Mugo Pine	7-Gal
45	TOTAL		

VINES


2	WJ	Wisteria Japonica (Patio Trallis)	5-Gal
2	TOTAL		

ORNAMENTAL GRASSES

77	KFG	Feather Reed Grass	5-Gal
32	BAG	Blue Avena Grass	5-Gal
109	TOTAL		

PERENNIALS

9	PIP	Purple Ice Plant	1-Gal
28	DZR	Dianthus Zing Rose	1-Gal
30	PCF	Purple Cone Flower	1-Gal
31	DLM	Daylily Mix	1-Gal
8	SW	Soapwort	1-Gal
17	GF	Gay Feather	1-Gal
7	PC	Pink Coreopsis	1-Gal
21	SI	Siberian Iris (Blue & White)	1-Gal
35	PRC	Purple Rock Cress	1-Gal
14	BS	Blue Salvia	1-Gal
77	PM	Poppy Mallow Purple	1-Gal
25	CB	Cranes Bill	1-Gal
11	EEH	Elephant Ear Hosta	1-Gal
313	TOTAL		

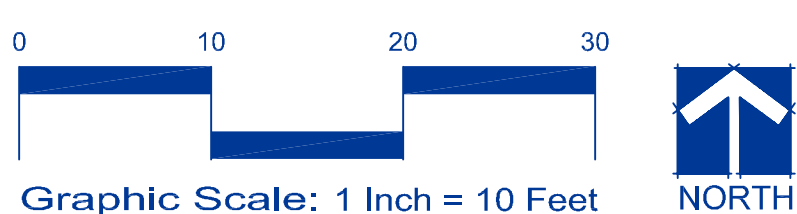

As-Built Landscape Plan

October 26, 2006 - October 17, 2006 - May 5, 2006 - August 9, 2005
Copyright © Land Architects International. All Rights Reserved.

LAND ARCHITECTS

perspective | balance | solutions

Highlands Ranch 303.734.1777 | Fort Collins 970.484.4100 | www.landarchitects.net