




1 HANDRAIL ELEVATION 'A'
SCALE: NTS

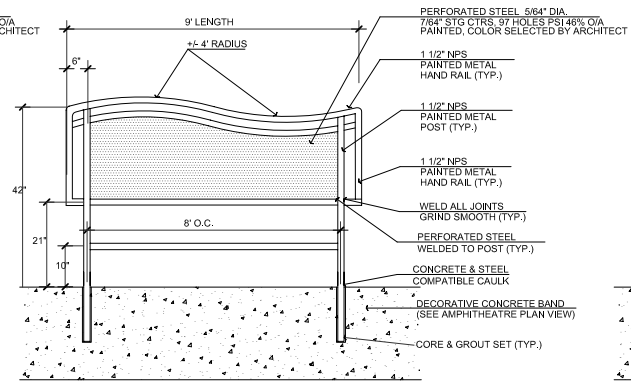


2 HANDRAIL ELEVATION 'B'
SCALE: NTS

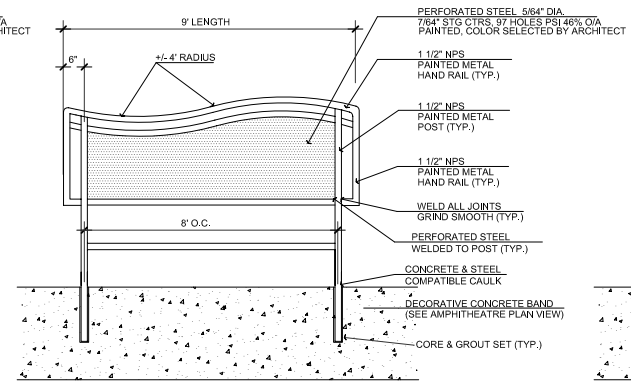


3 HANDRAIL ELEVATION 'C'
SCALE: NTS

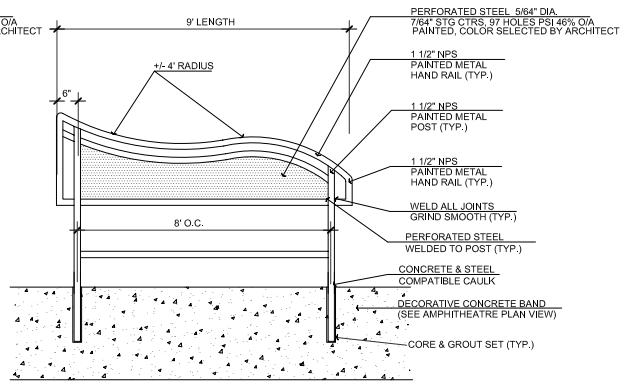


4 HANDRAIL ELEVATION 'D'
SCALE: NTS

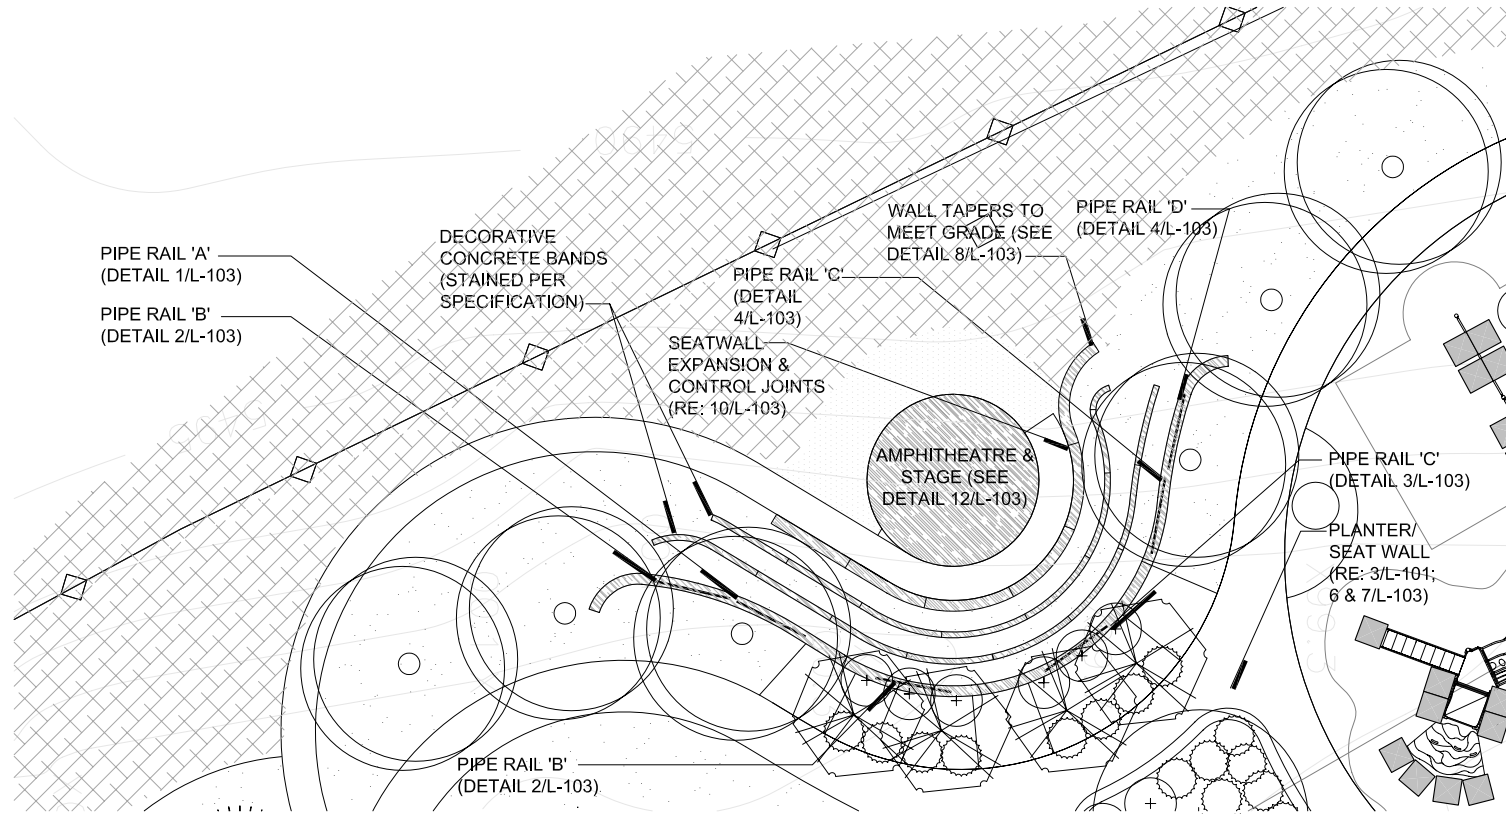


9 AMPHITHEATRE PLAN VIEW
SCALE: 1/8" = 1'-0"

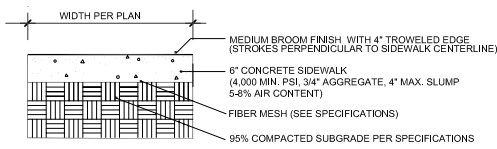


10 TYPICAL CONCRETE SIDEWALK SECTION
SCALE: NTS

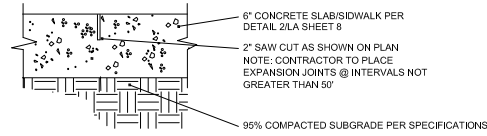

11 CONCRETE CONTROL JOINT
SCALE: NTS


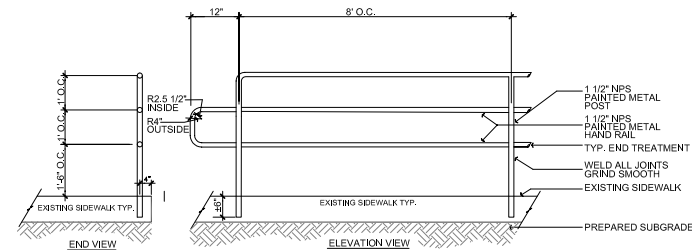


13 PEDESTRIAN HANDRAIL
SCALE: NTS

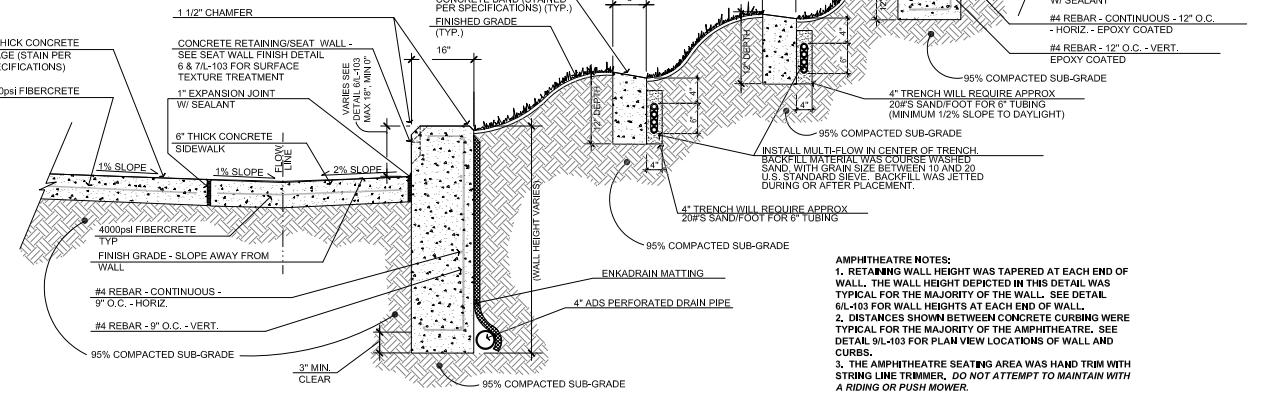


12 AMPHITHEATRE SECTION
SCALE: NTS

5 HANDRAIL FASTENER DETAIL
SCALE: NTS

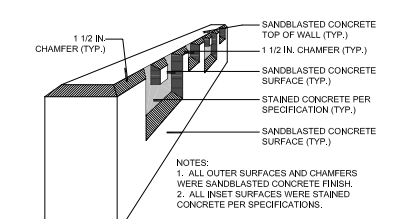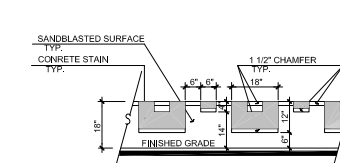

6 SEATING & PLANTER WALL FINISH
SCALE: NTS

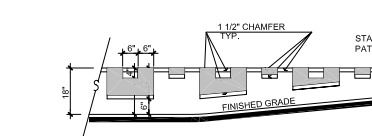


7 SEATING & PLANTER WALL FINISH
SCALE: NTS



8 TAPERED SEATING & PLANTER WALL FINISH
SCALE: NTS



REVISIONS		
NO.	DATE	DESCRIPTION

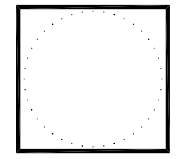

LAND ARCHITECTS
 Land Planning | Urban Design | Landscape Architecture | Park Planning
 9137 S. Regalene Blvd Suite 130, Highlands Ranch, CO 80129 | Ph: 303.734.1777 | Fr: 303.734.1778

TSP Five, Inc.
 8751 E. Hamrick Ave. Suite A-1
 Denver, Colorado
 (303) 695-1997 • Fax: (303) 695-1938
 503 Remington, Suite 5
 Ft. Collins, Colorado
 (970) 493-1772 • Fax: (970) 493-1820

New Building - Phase One
 Bear Creek K-8 School
 Lakewood, Colorado
 As Built
 Playground & Sidewalk Details

File Name: C:\11-17.dwg
 Project No.: 00063
 Drawn By: JLM
 Checked By: LM
 Date: 04/05/02
 Copyright © 2002